KEY PLAN

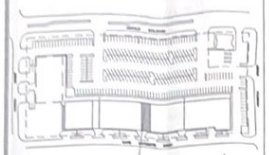

DOOR TYPES

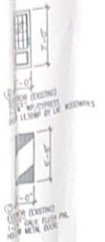

FRAME TYPES

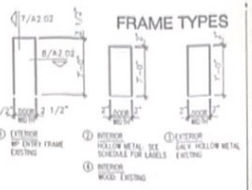

DOOR SCHEDULE

NO.	DOOR WIDTH	DOOR TYPE	DOOR THK.	FRAME TYPE	FRAME THK.	HARDWARE SET	HARDWARE SIGN	SPECIAL CONDITIONS LABEL	SPECIAL CONDITIONS REMARKS
101	-	A	1 3/4"	F10	6"	1			EXISTING
102	-	A	1 3/4"	F10	6"	1			EXISTING
103	-	A	1 3/4"	F10	6"	1			
104	-	A	1 3/4"	F10	6"	1			
105	-	A	1 3/4"	F10	6"	1			
106	-	A	1 3/4"	F10	6"	1			EXISTING

NOTE
DOORS AND FRAMES SCHEDULED TO RECEIVE N.F. (NATURAL FINISH) SHALL RECEIVE ONE (1) COAT OF STAIN/SEALER AND TWO (2) COATS OF VARNISH

DOOR 102 TO RECEIVE 1835P - STEEL, GRAY PRIME ASTRAGAL MANUF. BY REESE

HARDWARE

MANUFACTURERS
HINGES - HAGER
LOCKS - SCHLAGE
CYLINDERS - SCHLAGE
EXIT DEVICES - VON DUPRIN
CLOSERS - LCN
PUSH & PULLS - TRIMCO
HOLDERS - N/A
THRESHOLDS - PEMKO
FLUSHBOLTS - IVES

SET NO. 1
RE-USE EXISTING

SET NO. 2
RE-USE EXISTING
ADD:
1 - ALUM. THRESHOLD
1 - SET OF WEATHER-STRIPPING

SET NO. 3
1.5 PR - HINGES
1 - OFFICE LOCK/SET-LEVER HANDLE
1 - WALL OR FLOOR BUMPER
AS REQUIRED

SET NO. 4
1.5 PR - HINGES
1 - PASSAGE LATCHSET - LEVER HANDLE
1 - WALL OR FLOOR BUMPER
AS REQUIRED

SET NO. 5
1.5 PR - HINGES
1 - PRIVACY LATCHSET - LEVER HANDLE
1 - WALL OR FLOOR BUMPER
AS REQUIRED

GUIDRY BEAZLEY
architects
A PROFESSIONAL CORPORATION
318 235 0614
FAX 235 7308
P.O. BOX 54377
LAFAYETTE, LOUISIANA 70505

AMERICAN GENERAL FINANCE
TENANT BUILD OUT
THE BOULEVARD SHOPPING CENTER
ARNOULD BOULEVARD
LAFAYETTE, LOUISIANA

DEMOLITION NOTES:

1. EXISTING SUSPENDED CEILING TO REMAIN AS IS.
2. EXISTING SUSPENDED CEILING TO BE REMOVED. SALVAGE ACOUSTICAL TILE TO BE REUSED.
3. EXISTING LIGHT FIXTURE TO REMAIN AS IS.
4. EXISTING LIGHT FIXTURE TO BE REMOVED. SALVAGE AND REUSE AS REQUIRED TO ACHIEVE NEW LIGHTING LAYOUT.
5. EXISTING CEILING MOUNTED HVAC SUPPLY DIFFUSER TO REMAIN AS IS.
6. EXISTING CEILING MOUNTED HVAC SUPPLY DIFFUSER TO BE REMOVED. SALVAGE UNIT AND REUSE PER NEW HVAC LAYOUT.
7. EXISTING R/A CEILING GRILLE TO BE REUSED. REMOVE, CLEAN AND RE-INSTALL.

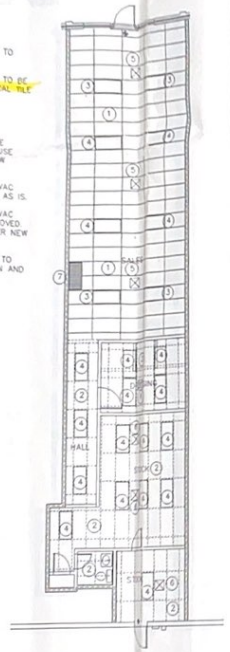

LEGEND

- EXIT LIGHT FIXTURE
- TRACK LIGHTING & LAMPS
- RECESSED INCANDESCENT LIGHT (EYEBALL)
- FLOURESCENT LIGHT FIXTURE
- LAY-IN LIGHT FIXTURE
- CLG. MTD. EXHAUST FAN
- RETURN AIR GRILLE

19 REFLECTED CEILING DEMOLITION PLAN (HOLLY & IVY)

DEMOLITION NOTES:

1. REMOVE EXISTING WALL IN ITS ENTIRETY. REMOVE AND DISCONNECT ANY ELECTRICAL, COMMUNICATION, PLUMBING OR MECHANICAL DEVICE IN WALL. CAP EXISTING PIPING BELOW FINISH SURFACES. MAINTAIN CIRCUITRY NEEDED FOR ITEMS TO REMAIN IN SERVICE.
2. REMOVE EXISTING DRESSING CUBICLES.
3. REMOVE EXISTING FLOORING.
4. REMOVE EXISTING MIRRORS AND ROUGH SAWN SIDING FROM CMU WALLS. SALVAGE.
5. REMOVE EXISTING WATER COOLER. TERMINATE SUPPLY AND DRAIN LINES BELOW FINISH SURFACES AND CAP. SALVAGE WATER COOLER.
6. REMOVE EXISTING BASE AND TOP CABINETS INCLUDING SINK. MODIFY PLUMBING AS REQUIRED TO RE-INSTALL SINK IN NEW CABINET.
7. REMOVE EXISTING TOILET AND LAVATORY. MODIFY PLUMBING TO REINSTALL TOILET AND LAVATORY TO COMPLY WITH ADA REQUIREMENTS.
8. REMOVE EXISTING DOOR AND FRAME. SALVAGE.
9. REMOVE EXISTING 110 V. RECEPTACLE. TERMINATE POWER FEEDS BELOW FINISH FINISH SURFACES OR MODIFY THEM TO PROVIDE POWER TO NEW OUTLET LOCATIONS.
10. REMOVE EXISTING TELEPHONE OUTLET. TERMINATE CONDUIT FEED BELOW FINISH SURFACE OR MODIFY IT TO PROVIDE RACEWAY FOR NEW COMMUNICATION OUTLET LOCATIONS.

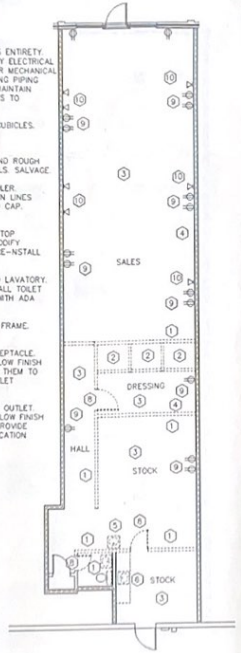

LEGEND

- DRYWALL PARTITION
- 1 HR FIRE WALL
- F.E.C. FIRE EXTINGUISHER CABINET W/ EXTINGUISHER

21 (HOLLY & IVY) DEMOLITION FLOOR PLAN

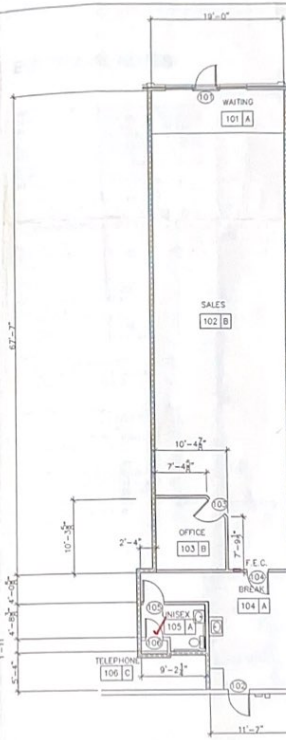

SEPARATE PRICING:

BID TO LANDLORD:

- WALLS DRYWALLED, TAPED, SANDED AND READY TO PAINT.
- FLOORS READY FOR FLOOR COVERING.
- HEATING & AIR CONDITIONING SYSTEM COMPLETED (MIN. 4 1/2 TONS) WITH ADEQUATE DUCTWORK.
- COMPLETED PLUMBING WITH ADA TOILET WITH HOT WATER SUPPLY AND HVAC DUCTWORK AND DIFFUSERS.
- NEW DROP CEILING COMPLETE WITH 2 X 4 ACOUSTICAL DROP-IN TILES AND RECESSED LIGHT FIXTURES.
- COMPLETED ELECTRICAL SYSTEM.
- CONSTRUCT REAR DEMISING WALL.

BID TO TENANT:

- WALLS PAINTED BENJ. MOORE #961 OFF WHITE FLAT FINISH ON ALL INTERIOR WALLS WITH TRIM PAINTED WITH THE SAME COLOR SATIN OR EGGSHELL FINISH (2 COATS).
- INSTALL AZROCK SLIP RESISTANT VCT WITH VINYL BASE IN THE FRONT OF THE OFFICE (TILE BY TENANT)
- INSTALL CARPET WITH 4" CARPET BASE (CARPET AND BASE BY TENANT)
- INSTALL VCT IN BREAKROOM WITH VINYL COVE BASE (MATERIALS BY CONTRACTOR)
- INSTALL VCT IN TOILET WITH VINYL COVE BASE (MATERIALS BY CONTRACTOR)
- SEE ELECTRICAL PLAN FOR WORK REQUIRED.
- CONSTRUCT 10' X 10' CLOSING ROOM.
- PROVIDE HVAC DUCTWORK AND DIFFUSERS INTO MAIN/FRONT OFFICE AREA.
- PURCHASE AND INSTALL FABRIC VERTICAL BLINDS OR HORIZONTAL MINI BLINDS - NON VINYL (WHITE, OFF-WHITE, OR SHADE OF BLUE TO MATCH CARPET)
- INSTALL SINK WITH CABINETS OVERHEAD & BENEATH IN BREAKRM WITH HOT & COLD WATER.

CABINETS CAN BE PRE-FABRICATE WITH 2' X 4' COUNTER TOP.

REVIEWED FOR STATE FIRE MARSHAL AS PER REVIEW LETTER BY KESTEE WEIR III PLAN REVIEW DEPUTY
Kestee Weir III
8-25-99

LEGEND

- DRYWALL PARTITION
- 1 HR FIRE WALL
- F.E.C. FIRE EXTINGUISHER CABINET W/ EXTINGUISHER

22 FLOOR PLAN

GENERAL NOTES

1. ALL WORK IS TO BE ACCOMPLISHED TO MEET ALL LOCAL, STATE, AND FEDERAL CODES AND ALL AUTHORITIES HAVING JURISDICTION.
2. THE CONTRACTOR WILL PROVIDE ALL NECESSARY BARRICADES, SIGNAGE, REFLECTORS, LIGHTS, ETC. DURING CONSTRUCTION. PROPERLY IDENTIFY AREAS CLOSED TO THE PUBLIC.
3. THE CONTRACTOR WILL REMOVE ALL RUBBLE AND DEBRIS FROM THE JOB SITE DAILY AND LEAVE THE BUILDING AND GROUNDS BROOM CLEAN UPON COMPLETION OF THE WORK.
4. CONTRACTOR IS RESPONSIBLE FOR THE LOCATION AND COORDINATION OF ALL CONDUIT, PIPING AND DUCTWORK WITH THE VARIOUS TRADES.
5. THE CONTRACTOR/S SHALL OBTAIN AND PAY FOR ALL NECESSARY PERMITS.
6. CONTRACTOR SHALL COORDINATE ALL WORK WITH THE OWNER INCLUDING BUT NOT LIMITED TO STAGING, ENTRY, USE OF FACILITIES, UTILITIES, SCHEDULING, SMOKING, EATING, ETC.

BUILDING INFORMATION

BUILDING CODES
STANDARD BUILDING CODE - 1994 EDITION
NFPA LIFE SAFETY - 1997 EDITION
ANSI A117.1 - 1998 EDITION
ADAAG - 1990

OCCUPANCY TYPE
SBC: GROUP M MERCANTILE
NFPA: MERCHANTILE CLASS B

CONSTRUCTION TYPE
SBC: TYPE IV UNPROTECTED
NFPA: TYPE II (000)

FIRE PROTECTION:
UNSPRINKLED- UNPROTECTED
FIRE RESISTANCE- NONE
MINIMUM OCCUPANT LOAD- 22

BUILDING AREA
SQ. FT. OF PROJECT: 1,648
NUMBER OF FLOORS: 1
TOTAL SQ. FT. OF BLDG: 56,272

PARKING
SPACES 320
HANDICAPPED SPACES: 9
ZONING: BG OF LAFAYETTE

DATE ISSUED	04/06/96
REVISED	
DRAWN BY	KAL
CHECKED BY	LLG
COMM. NO.	9201.B5
SHEET NO.	A2.01
OF	

FINISH TYPES

TYPE A:
FLOOR: VINYL COMPOSITION TILE
BASE: 4" VINYL BASE
WALLS: GYPSUM BOARD - PAINTED
CEILING: SUSPENDED ACOUSTICAL TILE

TYPE B:
FLOOR: CARPET
BASE: 4" CARPET BASE
WALLS: GYPSUM BOARD - PAINTED
CEILING: SUSPENDED ACOUSTICAL TILE

TYPE C:
FLOOR: VCT
BASE: 4" VINYL BASE
WALLS: GYPSUM BOARD - PAINTED
CEILING: NONE

LIGHT FIXTURE SCHEDULE

MARK	DESCRIPTION	LAMPS	VOLTS	MOUNTING	MANUFACTURER	CATALOG NO.
A	2X4 FLUORESCENT TROFFER - 4LAMP	48"	120	LAY-IN	LITHONIA	2SPG-432A12-120
A1	2X4 FLUORESCENT TROFFER - 4LAMP	48"	120	LAY-IN	LITHONIA	2SPG-432A12-120
B	2X4 FLUORESCENT TROFFER - 2LAMP	48"	120	LAY-IN	LITHONIA	2SPG-232A12-120
C	SELF CONTAINED EMERGENCY	SUPPLIED	120	SURFACE	LITHONIA	ELM-2
D	SINGLE FACED EXIT SIGN LIGHT	5W PL	120	UNIVERSAL	LITHONIA	F2GM-S-W-1-R-120-EL

SCHEDULE NOTES:

FIXTURES LISTED IN SCHEDULE ARE FOR DESIGN STANDARD ONLY. ACTUAL FIXTURES MAY DIFFER. FIXTURES MARK A ARE EXISTING FIXTURES TO REMAIN WHERE THERE ARE. FIXTURES AT ARE EXISTING FIXTURES TO BE RE-LOCATED TO NEW LOCATIONS SHOWN.

FIXTURES B, C, AND D WILL BE NEW FIXTURES, UNLESS OWNER CAN FURNISH SIMILAR FIXTURES TAKEN FROM CENTER.

GUIDRY BEAZLEY
architects
A PROFESSIONAL CORPORATION
318 233 0614
FAX 233 7338
P.O. BOX 51877
LAFAYETTE, LOUISIANA 70505

AMERICAN GENERAL FINANCE
TENANT BUILD OUT
THE BOULEVARD SHOPPING CENTER
ARNOULD BOULEVARD
LAFAYETTE, LOUISIANA

TENANT FURNISHINGS:

A TENANT FURNISHED CHAIR (NO ELECTRICAL)
B TENANT FURNISHED TABLE (110 VOLT OUTLET)
C TENANT FURNISHED TABLE (NO ELECTRICAL)
D TENANT FURNISHED TABLE (NO ELECTRICAL)
E TENANT FURNISHED FILES (NO ELECTRICAL)
F TENANT FURNISHED STORAGE UNIT (NO ELECTRICAL)
G TENANT FURNISHED WORK STATION (1-SINGLE GANG BOX FOR ELECT. & 1-SINGLE GANG BOX FOR VOICE/DATA. BOTH REQUIRE 3/4" CONDUITS. OUTLETS LOCATED LESS THAN 6" OFF FLOOR TO TOP EDGE)
H TENANT FURNISHED DIAGONAL DESK UNIT (ELECTRICAL & VOICE/DATA THROUGH G)
J TENANT FURNISHED TABLE (110 VOLT OUTLET)
K TENANT FURNISHED MOVABLE OFFICE PARTITION (NO ELECTRICAL)
L TENANT FURNISHED TECH COUNTER (2-SINGLE GANG BOX FOR ELECT. DEDICATED & 2-SINGLE GANG BOX FOR VOICE/DATA. BOTH REQUIRE 3/4" CONDUITS. NO OUTLETS NEEDED , WHIPS TO CONNECT TO TECH CENTER)
M N O TENANT FURNISHED FRONT COUNTER COMPONENTS (2-SINGLE GANG BOX FOR ELECT. DEDICATED & 2-SINGLE GANG BOX FOR VOICE/DATA. BOTH REQUIRE 3/4" CONDUITS. NO OUTLETS NEEDED , WHIPS TO CONNECT TO FRONT COUNTER)

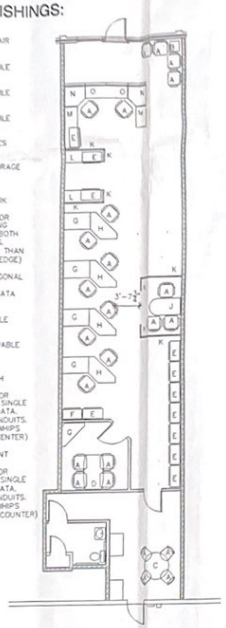

N
PLAN NORTH
LEGEND
DRYWALL PARTITION
1 HR FIRE WALL
F.E.C. FIRE EXTINGUISHER CABINET W/ EXTINGUISHER
0 8'

23 FURNISHINGS FLOOR PLAN

PLUMBING NOTES:

1. PROVIDE A 6 GALLON STORAGE ELECT. WATER HEATER ON PLATFORM ABOVE CEILING. HEATER SHALL HAVE 2000 WATT ELEMENT, 120/1/60 ELECT. SERVICE, RUUD PE6-1 OR EQUAL. PROVIDE A 20 GUAGE GALV. DRAIN PAN BELOW WATER HEATER. PROVIDE EMERGENCY DRAIN PAN LINE FROM DRAIN PAN TO EXTERIOR WALL, DROP IN WALL TO 6" ABOVE FINISHED FLOOR, TURN TO EXTERIOR & TERMINATE DOWN. SEAL ALL WALL PENETRATIONS WEATHERTIGHT.
2. WATER CLOSET SHALL BE KOHLER K-3544 OR EQUAL, 17 1/2" HIGH, VITREOUS CHINA, 1.5 GALLON PRESSURE CLEAN FLUSH, ELONGATED BOWL WATER CLOSET. PROVIDE K-4870-C SOLID PLASTIC SEAT WITH OPEN FRONT & CHECK HINGE. PROVIDE BOLT CAPS & 3/8" ANGLE SUPPLY WITH STOP.
3. LAVATORY SHALL BE KOHLER K-2030 OR EQUAL WALL HUNG VITREOUS CHINA LAVATORY, K-13328-5 FAUCET WITH WRIST BLADE HANDLES, K-13885 OFFSET DRAIN WITH STRAINER, 17 GA.P-TRAP WITH C.O. PLUG, 3/8" ANGLE SUPPLIES WITH STOPS, AND TRUEBRO MODEL 102 INSULATION KIT WITH 105 OFFSET.
4. PROVIDE A EXHAUST FAN ABOVE CEILING WITH W.B.E. GRILLE, BACKDRAFT DAMPER & MOUNTING BRACKETS. FAN CAPACITIES SHALL BE: 90 CFM. EXHAUST @ .25" SP, 2.9 SONES, 80 WATT MOTOR, 120/1/60 ELEC. SERVICE ACME V100 OR EQUAL. SWITCH FAN WITH RESTROOM LIGHTS. PROVIDE A ALUM. WALL CAP WITH BACKDRAFT DAMPER & BIRDSCREEN. PAINT WALL CAP COLOR TO MATCH BLDG. RUN 10" X 4" EXHAUST DUCT FROM FAN TO WALL CAP.
5. RE-INSTALL EXISTING IN COUNTER SINK PROVIDE NEW FITTINGS AND/OR STOPS AS REQUIRED. CLEAN UNIT PRIOR TO INSTALLATION. TO PROVIDE "LIKE NEW" APPEARANCE.

HVAC NOTES:

1. EXISTING 5 TON UNIT ON ROOF-TOP TO REMAIN IN USE.
2. MODIFY EXISTING DUCT WORK TO ALLOW FOR THE RELOCATION OF EXISTING CEILING DIFFUSERS.

SERVICE EXISTING UNIT, RECHARGING REFRIGRATE AND BALANCING DUCTWORK.

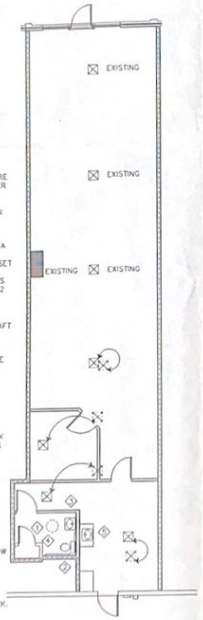

N
PLAN NORTH
LEGEND
DRYWALL PARTITION
1 HR FIRE WALL
F.E.C. FIRE EXTINGUISHER CABINET W/ EXTINGUISHER
0 8'

23 PLUMBING/HVAC PLAN

ELECTRICAL NOTES:

AMERICAN GENERAL'S DESKS (WORKSTATIONS) HAVE A PANEL THAT WILL BLOCK THE ENTIRE WALL EXCEPT FOR 6" ALONG THE BOTTOM. IT IS IMPORTANT TO LOCATE RECEPTACLES AS CLOSE TO THE FLOOR AS POSSIBLE, EVEN ROTATING THEM 90 DEGREES. FOR ANY WORKSTATION THAT IS NOT AGAINST A FLOOR RECEPTACLE WILL BE NEEDED.
NO POWER POLES OR EXTERIOR CONDUIT!

- SEE NOTES ON FIXTURE PLAN FOR CONDUIT SERVICE TO WORKSTATIONS AND FRONT COUNTER / TECH CENTER.
- NO POWER POLES OR EXTERIOR CONDUIT AT EITHER LOCATION.

THIS BULDING IS SERVICED BY 120/208 V. 3-PHASE POWER. PROVIDE THE FOLLOWING @ FRONT COUNTER
3-WIRE 110 DEDICATED CIRCUIT (1WIRE +GROUND + NEUTRAL) RATED @ 20 AMP.

TECH CENTER
5-WIRE 110 DEDICATED CIRCUIT (3 WIRES + GROUND + NEUTRAL) RATED @ 20 AMP.

COMPUTER/TELEPHONES
1- 110 DEDICATED CIRCUIT FOR MAIN COMPUTER LOCATED BY POWER PANEL NEAR TOILET ROOM.

1- 110 DUPLEX OUTLET @ TELEPHONE BACKBOARD PROVIDE 3/4" CONDUIT RUN FROM TELEPHONE COMPANY'S BOX ON REAR WALL OF BLDG. INTO TELEPHONE CLOSET.

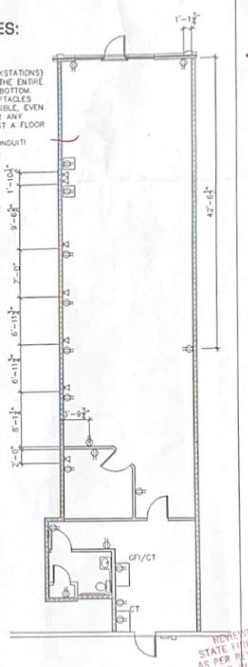

APPROVED FOR STATE FIRE MARSHAL AS PER REVIEW LETTER BY KESTER WEIR, III PLAN REVIEW DEPUTY
Kester Weir III

N
PLAN NORTH
LEGEND
DRYWALL PARTITION
1 HR FIRE WALL
F.E.C. FIRE EXTINGUISHER CABINET W/ EXTINGUISHER
0 8'

23 POWER/SPECIAL SYSTEMS PLAN

LIGHTING NOTES:

1. ALL LIGHTING AND POWER WORK SHALL BE DONE IN STRICT ACCORDANCE WITH NATIONAL ELECTRICAL CODE.

ELECTRICAL CONTRACTOR WILL BE REQUIRED TO FURNISH LOCAL INSPECTOR WITH NECESSARY CONNECTED LOAD FIGURES AND NEED RISER DIAGRAM AS REQUIRED FOR ISSUANCE OF ELECTRICAL PERMIT.

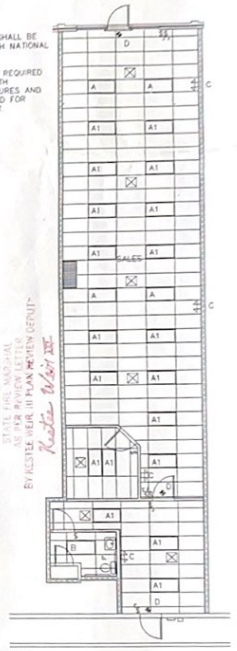

APPROVED FOR STATE FIRE MARSHAL AS PER REVIEW LETTER BY KESTER WEIR, III PLAN REVIEW DEPUTY
Kester Weir III

N
PLAN NORTH
LEGEND
EXIT LIGHT FIXTURE
TRACK LIGHTING & LAMPS
RECESSED INCANDESCENT LIGHT (EYEBALL)
FLOURESCENT LIGHT FIXTURE
LAY-IN LIGHT FIXTURE
CLG. MTD. EXHAUST FAN
RETURN AIR GRILLE
0 8'

22 REFLECTED CEILING LIGHTING PLAN

GRANT L. GUIDRY
REGISTERED ARCHITECT

DATE ISSUED	04/08/96
REVISED	
DRAWN BY	KAL
CHECKED BY	LLG
COMM. NO.	9201.B5
SHEET NO.	A2.01
OF	